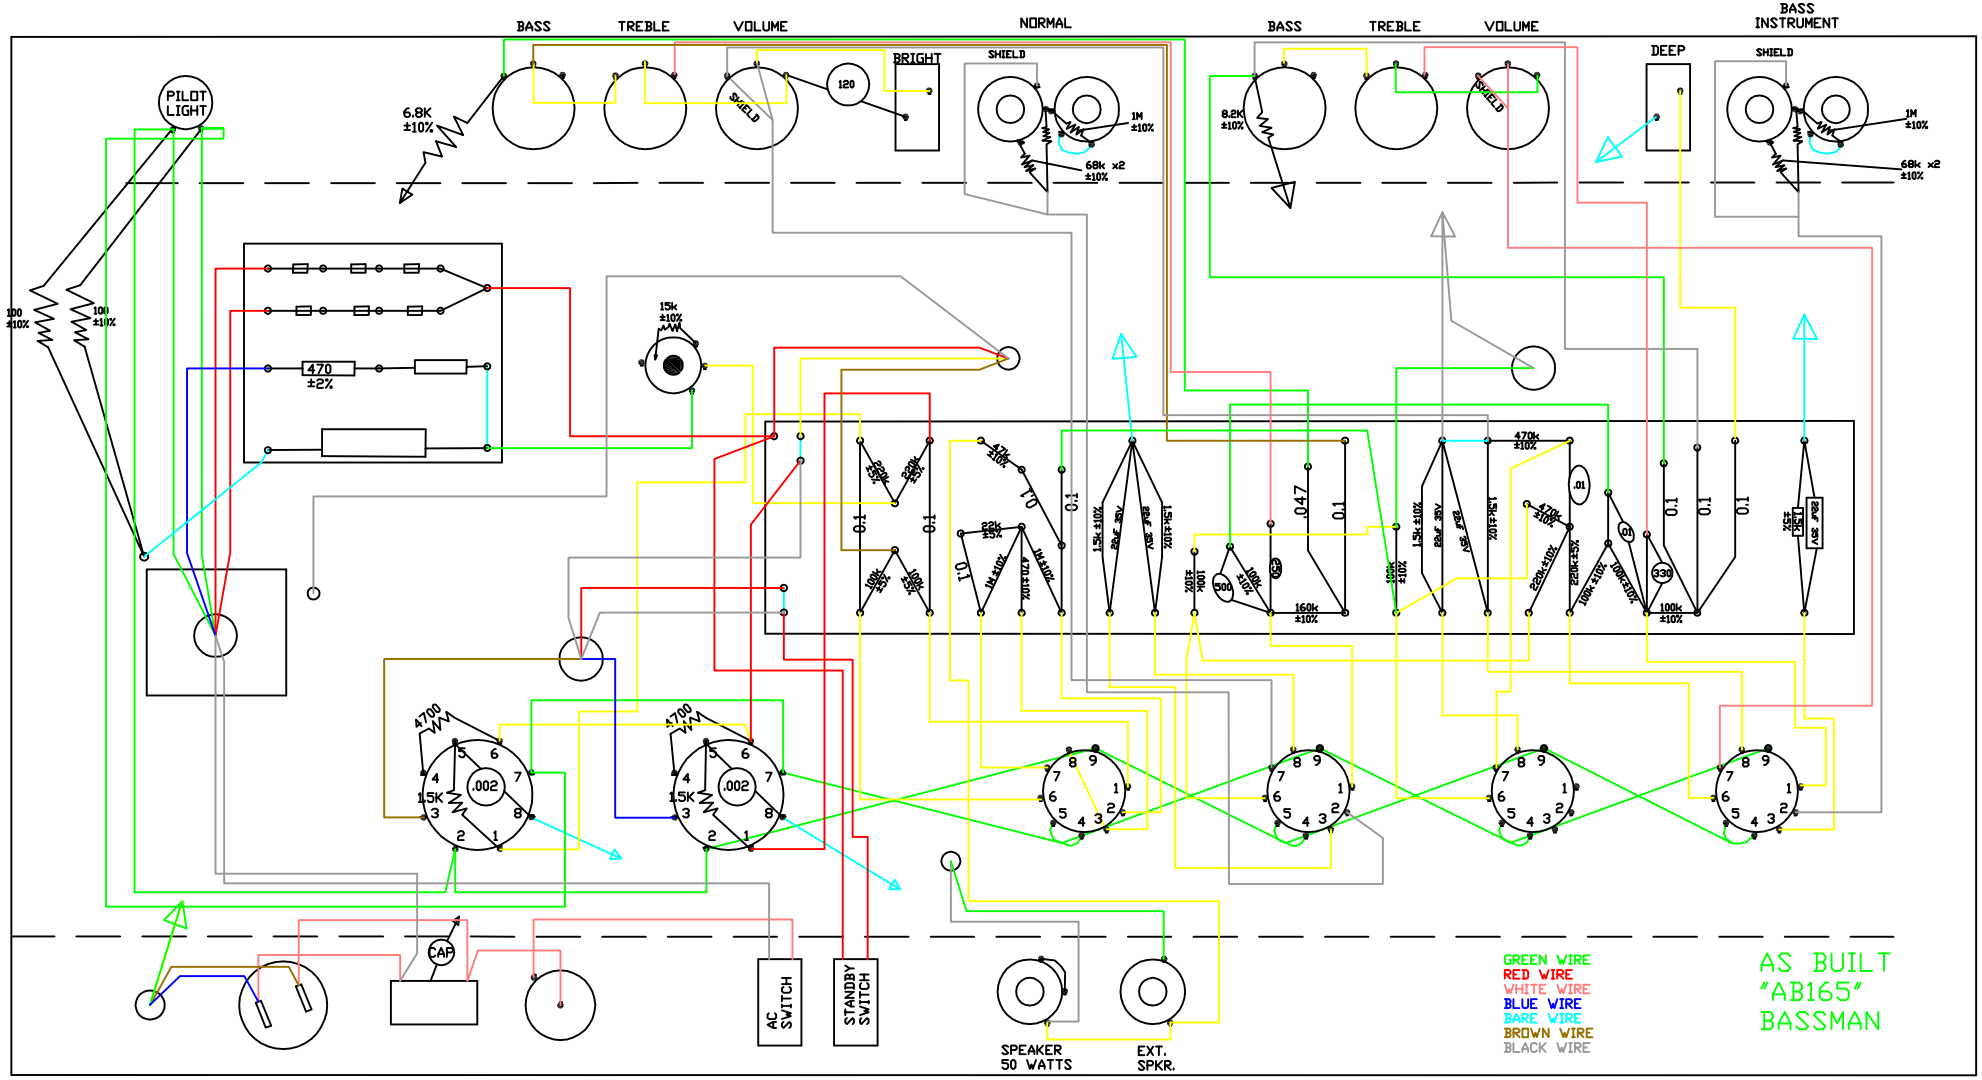
BASS
TREBLE
VOLUME
NORMAL
BRIGHT
SHIELD
BASS
TREBLE
VOLUME
DEEP
BASS INSTRUMENT
SHIELD
PILOT LIGHT
6.8K ±10%
120
1M ±10%
68k x2 ±10%
8.2K ±10%
100 ±10%
470 ±2%
15k ±10%
470k ±10%
.047
0.1
.01
160k ±10%
220k ±10%
100k ±10%
1.5k ±10%
22uF 35V
4700
15K
.002
CAP
AC SWITCH
STANDBY SWITCH
SPEAKER 50 WATTS
EXT. SPKR.
GREEN WIRE
RED WIRE
WHITE WIRE
BLUE WIRE
BARE WIRE
BROWN WIRE
BLACK WIRE
AS BUILT
"AB165"
BASSMAN